

# A d d e n d u m

Iowa Department of Transportation  
Office of Contracts

Date of Letting: March 21, 2017  
Date of Addendum: March 8, 2017

<b>B.O.</b>	<b>Proposal ID</b>	<b>Proposal Work Type</b>	<b>County</b>	<b>Project Number</b>	<b>Addendum</b>
102	07-1185-635	PCC PAVEMENT - GRADE AND NEW	BLACK HAWK	STP-U-1185(635)--70-07	21MAR102A02

Make the following changes to the PROPOSAL SCHEDULE OF PRICES:

Change Proposal Line No. 0080 2115-0100000 MODIFIED SUBBASE:

From: 15,686.900 CY

To: 15,832.100 CY

Change Proposal Line No. 0140 2301-1033090 STANDARD OR SLIP FORM PORTLAND CEMENT CONCRETE PAVEMENT, CLASS C, CLASS 3 DURABILITY, 9 IN.:

From: 41,525.500 SY

To: 38,414.900 SY

Add Proposal Line No. 0145 2301-4875006 MEDIAN, P.C. CONCRETE, 6 IN.; 352.900 SY

Change Proposal Line No. 0690 2511-0302600 RECREATIONAL TRAIL, PORTLAND CEMENT CONCRETE, 6 IN.:

From: 8,205.300 SY

To: 9,602.700 SY

Change Proposal Line No. 0730 2515-2475007 DRIVEWAY, P.C. CONCRETE, 7 IN.:

From: 1,146.000 SY

To: 1,421.300 SY

If the above changes are not made, they will be made as shown here.

Make the following change to the PLAN:


Add to the ESTIMATE REFERENCE INFORMATION: 2301-103309 STANDARD OR SLIP FORM PORTLAND CEMENT CONCRETE PAVEMENT, SY CLASS C, CLASS 3 DURABILITY, 9 IN.

Approximately 122.2 SY Temporary Pavement shall be incidental to this item.

Add to the ESTIMATE REFERENCE INFORMATION: 2301-4875006 Quantity is for 6" PCC Median Pavement at approaches to the roundabout at Greenhill Road and University Avenue. Modified subbase shall be used under median pavement, and is included in the quantity for Modified Subbase.

Replace Sheets B.1, C.11, C.15, C.19, L.6 and L.9 with the attached B.1, C.11, C.15, C.19, L.6 and L.9

Notes:  
Normal section shown may be appropriately modified for areas specifically designated by the engineer such as intersections or superelevated curves.  
Refer to other drawings for details of shoulder design and construction  
Earth Shoulder fill requires approximately 11.8 cubic yards of excavation, including 30% for shrinkage, per shoulder per station.

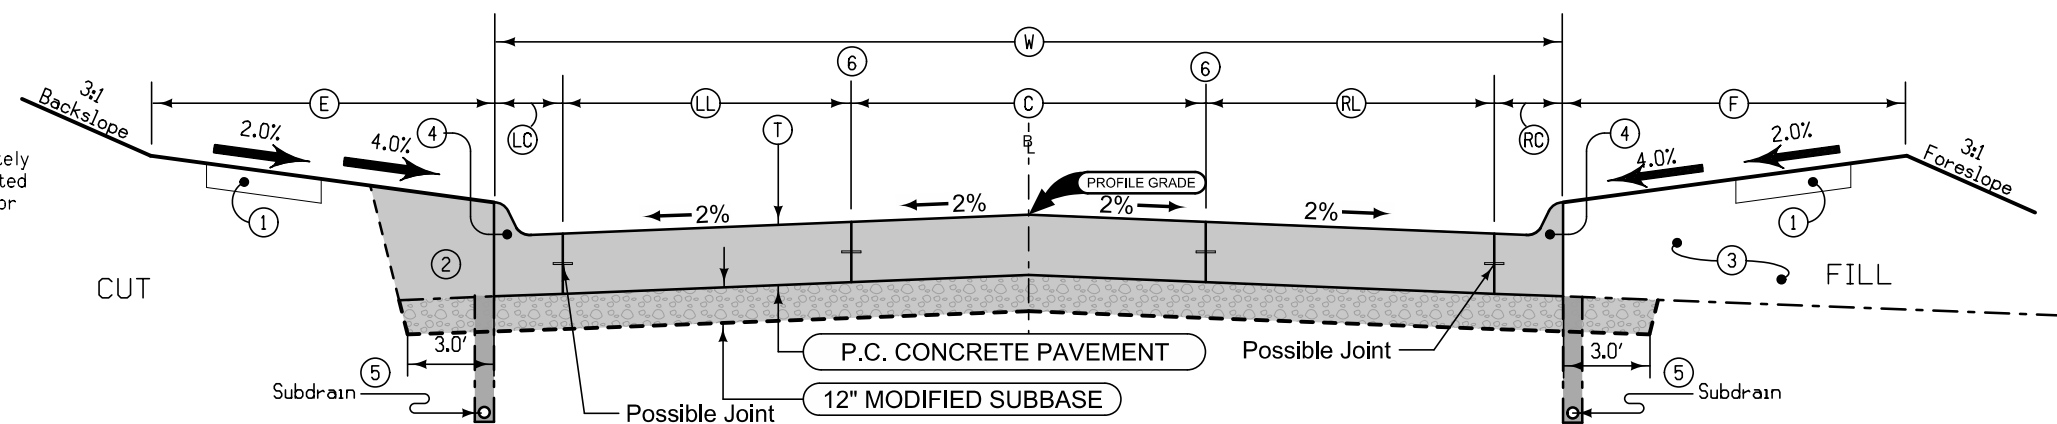


- ① Refer to other drawings for details of shoulder and possible sidewalk construction
- ② Excavate and backfill 3.0'
- ③ Backfill
- ④ 6" Standard or Sloped Curb, see Detail Drawing [6127] and [6128] (Use Sloped Curb South of University Ave.)
- ⑤ Refer to Standard Road Plan DR-303
- ⑥ Horizontal Alignment Control Point See Plan and Profile Sheets

**TYPICAL CROSS SECTION  
2 LANE WITH CENTER TURN LANE  
WITH 6" CURB**

Location		LC	LL	C	RL	RC	W	T	E	F	Location		LC	LL	C	RL	RC	W	T	E	F		
Road Identification	Station to Station	Feet	Feet	Feet	Feet	Feet	Feet	Inches	Feet	Feet	Road Identification	Station to Station	Feet	Feet	Feet	Feet	Feet	Feet	Inches	Feet	Feet		
GREENHILL ROAD	78+36.14	80+10.20	2.5	12.0	12.0	12.0	2.5	41.0	9	22.0	17.0	GREENHILL ROAD	126+95.00	129+95.00	3.5-2.5	12.0	0.0-12.0	12.0	3.5-2.5	31.0-41.0	9	22.0	17.0
GREENHILL ROAD	80+10.20	81+85.20	2.5-3.5	12.0	12.0-0.0	12.0	2.5-3.5	41.0-31.0	9	22.0	17.0	GREENHILL ROAD	129+95.00	133+30.00	2.5	12.0	12.0	2.5	41.0	9	22.0	17.0	
GREENHILL ROAD	121+10.00	121+43.55	3.3-3.5	12.0	8.0-7.7	12.0	3.5	38.8-38.7	9	22.0	17.0	GREENHILL ROAD	133+30.00	136+30.00	2.5-3.5	12.0	12.0-0.0	12.0	2.5-3.5	41.0-31.0	9	22.0	17.0
GREENHILL ROAD	121+43.55	124+33.21	3.5	12.0	7.7-0.0	12.0	3.5	38.7-31.0	9	22.0	17.0												


Notes:  
Normal section shown may be appropriately modified for areas specifically designated by the engineer such as intersections or superelevated curves.  
Refer to other drawings for details of shoulder design and construction  
Earth Shoulder fill requires approximately 11.8 cubic yards of excavation, including 30% for shrinkage, per shoulder per station.

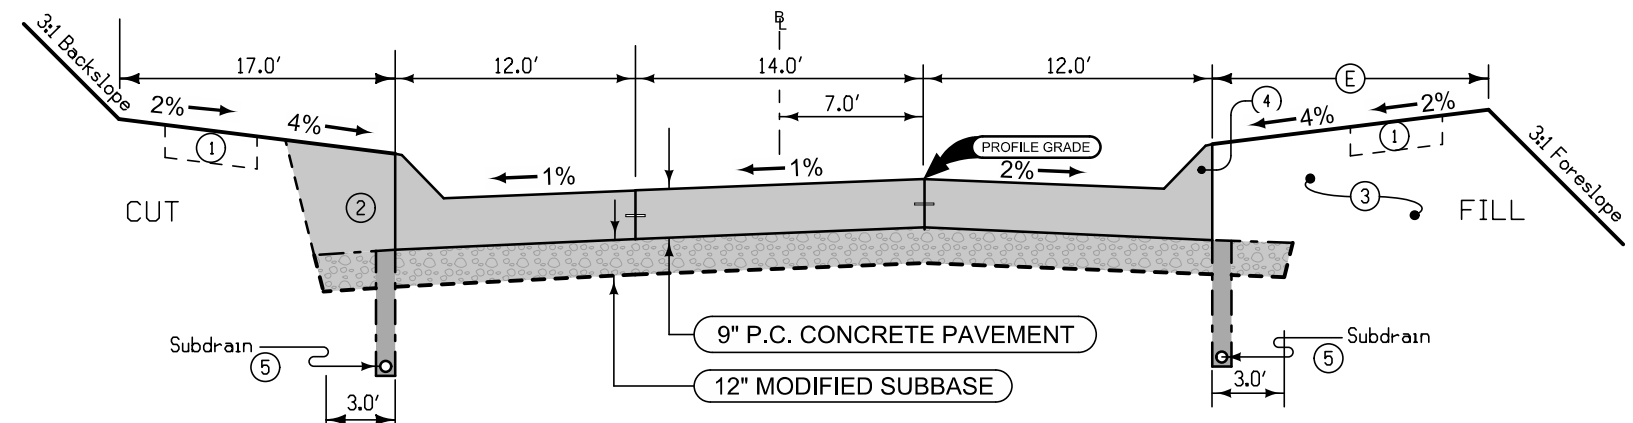

- ① Refer to other drawings for details of shoulder and possible sidewalk construction
- ② Excavate and backfill 3.0'
- ③ Backfill
- ④ 6" Standard or Sloped Curb, see Detail Drawing [6127] and [6128]
- ⑤ Refer to Standard Road Plan DR-303

**TYPICAL CROSS SECTION  
3-LANE URBAN WITH  
CENTER TURN-LANE**

LOCATION		E	
ROAD IDENTIFICATION	STATION TO STATION	Feet	
UNIVERSITY AVENUE	3192+00.00	3199+50.00	7
UNIVERSITY AVENUE	3199+50.00	3207+00.00	12

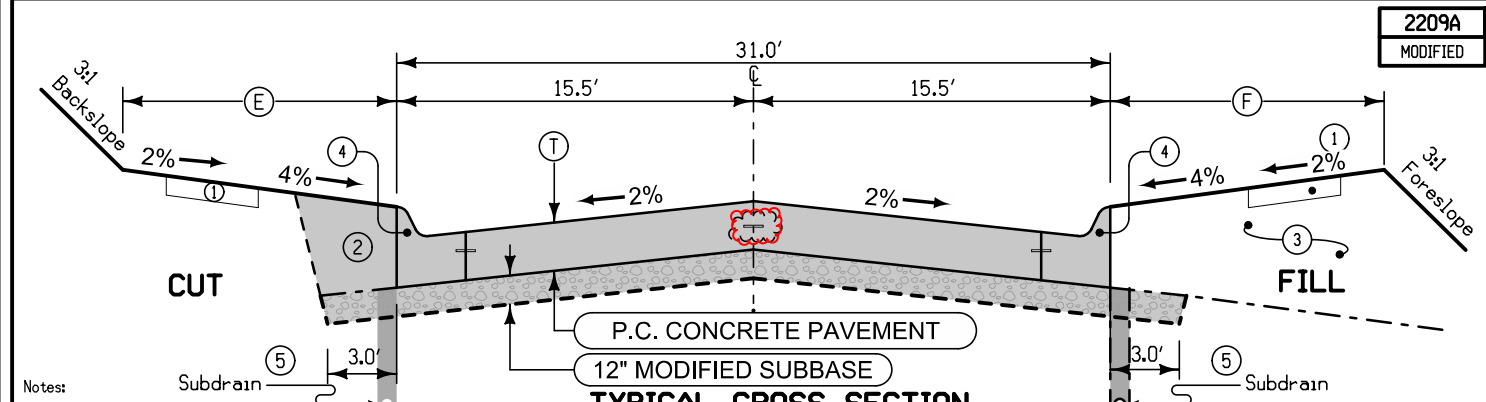


Notes:  
Normal section shown may be appropriately modified for areas specifically designated by the engineer such as intersections or superelevated curves.  
Refer to other drawings for details of shoulder design and construction  
Earth Shoulder fill requires approximately 11.8 cubic yards of excavation, including 30% for shrinkage, per shoulder per station.

LOCATION		T	E	F	
ROAD IDENTIFICATION	STATION TO STATION	Inches	Feet	Feet	
GREENHILL ROAD	81+85.20	116+00.00	9	22	17
GREENHILL ROAD	124+33.21	126+95.00	9	22	17
GREENHILL ROAD	136+30.00	143+69.44	9	22	17
UNIVERSITY AVENUE	3182+50.00	3186+00.00	9	12	17

- ① Refer to other drawings for details of shoulder and possible sidewalk construction
- ② Excavate and backfill 3.0'
- ③ Backfill
- ④ 6" Standard or Sloped Curb Use Sloped Curb S. of University
- ⑤ Refer to Standard Road Plan DR-303

**TYPICAL CROSS SECTION  
2 LANE 31' B-B WITH 3.5' CURB SECTION**

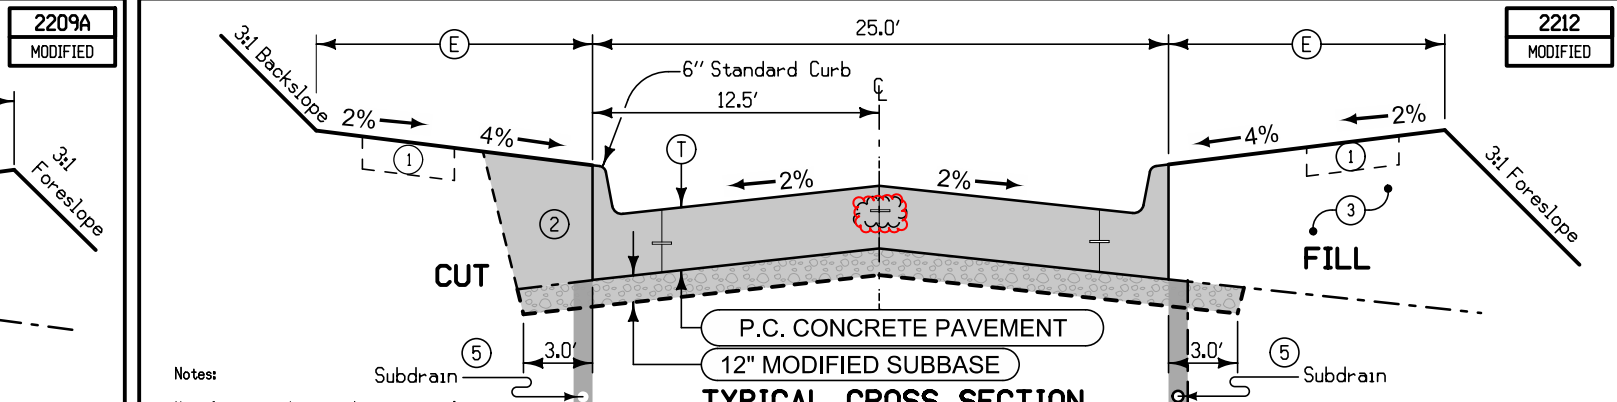

Notes:  
Normal sections shown may be appropriately modified for areas specifically designated by the engineer such as intersections or superelevated curves.  
Refer to other drawings for details of shoulder design and construction.  
Earth Shoulder fill requires approximately 11.8 cubic yards of excavation, including 30% for shrinkage, per shoulder per station.


LOCATION		T	E	
ROAD IDENTIFICATION	STATION TO STATION	Inches	Feet	
W. 31ST STREET	2091+15.50	2094+54.24	7	17.5

- ① Refer to other drawings for details of shoulder and possible sidewalk construction
- ② Excavate and backfill 3.0'
- ③ Backfill
- ④ 6" Standard Curb
- ⑤ Refer to Standard Road Plan DR-303

**TYPICAL CROSS SECTION  
2-LANE 25' BACK TO BACK ROADWAY WITH CURBS**



PCC PAVEMENT

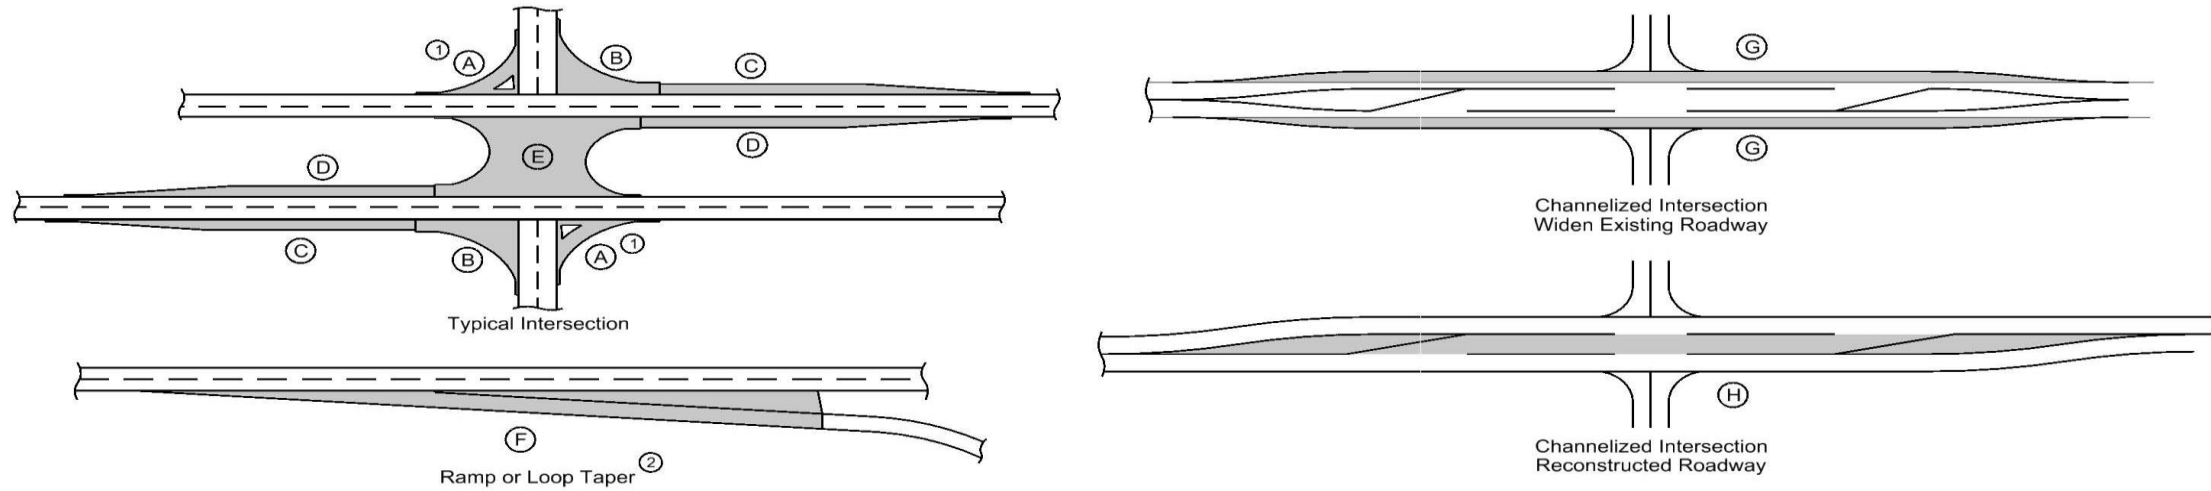

- ① Does not include raised island area or curb. Refer to tabulation 112-4 for quantities.
- ② Refer to PV-410, PV-411, PV-412, and PV-414.
- ③ Quantity includes Pavement Header.

Road Identification	Location Direction of Travel	Station to Station	Mainline			Area ③										Total Area By Pavement Thickness		Special Backfill TONS	Modified Subbase CY	Granular Subbase SY	Remarks
			Width	Length	Area	A ①	B	C	D	E	F ②	G	H	9 IN	7 IN						
			FT	FT	SY	SY	SY	SY	SY	SY	SY	SY	SY	SY	SY						
W. 27th St.		1063+53.20 1080+91.10		1737.9												2741.2	2741.2		1073.5		
W. 27th St.		1068+22.30 1069+79.10	5.0	156.8	87.1												87.1			Modified Subbase Included with North GHRD Paving Area	
W. 27th St.		1075+90.00 1081+06.30		516.3				688.0									688.0		358.5		
UNI Access Road		986+83.50 987+24.50	24.0	41.0	109.3	38.8	39.6										187.7		65.5		
W. 31st St.		2091+15.50 2094+54.20	25.0	338.7	940.8	43.6	44.0											1028.4	407.2		
Univesity Avenue		3181+00.00 3186+38.50	24.0	538.5	1436.0							0.0					1436.0		934.3	West UA Paving Area	
Univesity Avenue		3182+30.00 3186+38.50		408.5				151.6	155.0								306.6			Modified Subbase Included with West UA Paving Area	
Univesity Avenue		3186+38.50 3187+89.93		151.4	536.3												536.3			Modified Subbase Included with West UA Paving Area	
Univesity Avenue		3189+22.55 3192+00.00		277.5	1065.6												1065.6			Modified Subbase Included with East UA Paving Area	
Univesity Avenue		3192+00.00 3207+00.00	38.0	1500.0	6333.3												6333.3		2885.3	East UA Paving Area	
Greenhill Rd.		78+41.30 96+30.00	31.0	1788.7	6161.1												6161.1		2742.1	North GHRD Paving Area	
Greenhill Rd.		78+41.30 81+85.20		343.9		105.2	184.9	111.6	83.1								484.8			Modified Subbase Included with North GHRD Paving Area	
Greenhill Rd.		98+40.00 116+12.10	31.0	1772.1	6103.9												6103.9		2818.6	Central GHRD Paving Area	
Greenhill Rd.		116+12.10 118+04.00		191.9				710.4									710.4			Modified Subbase Included with Central GHRD Paving Area	
Greenhill Rd.		119+38.80 120+60.00		121.2				276.8	238.7								515.5			Modified Subbase Included with South GHRD Paving Area	
Greenhill Rd.		120+60.00 143+69.55	31.0	2309.6	7955.1												7955.1		3785.5	South GHRD Paving Area	
Greenhill Rd.		120+60.00 124+23.30		363.3				165.4									165.4			Modified Subbase Included with South GHRD Paving Area	
Greenhill Rd.		128+20.00 135+05.00		685.0								566.6					566.6			Modified Subbase Included with South GHRD Paving Area	
Greenhill Rd.		143+69.55 145+79.43	15.5	209.9	361.5												361.5			Modified Subbase Included with South GHRD Paving Area	
Greenhill Rd.		146+66.00 149+52.30		286.3						34.1	386.2						420.3		171.1		
Roundabout		10+00.00 12+95.30	34.0	295.3	1139.3			449.2									1588.5		590.5	Includes Interior of Roundabout Behind 4" Sloped Curb.	

BRIDGE APPROACH SECTION

112-6  
10-20-15

Refer to the BR Series.

\* Not a bid item

Bridge Station	End	Location		Approach Pavement					Standard Road Plans BR Series			Subdrain					Remarks		
		Skew Ahead		Thickness Inches	Pay Length FT	Non-Reinf. Pavement Area SY	Single-Reinf. Pavement Area SY	Double-Reinf. Pavement Area SY	Approach	Fixed or Movable Abutment	Abutting Pavement	Perforated Subdrain 4"	Subdrain Outlet		Porous Backfill CY	Class 'A' Crushed Stone Backfill CY		Modified Subbase TON	Polymer Grid SY
		LEFT	RIGHT										STA	Side					
97+35.00	N	0	0	10.0	70.0	103.3	68.9	70.3				125.0	96+39.58	LT	4.0	-	275.000	280.0	
97+35.00	S	0	0	10.0	70.0	103.3	68.9	70.3				125.0	98+30.42	LT	4.0	-	275.000	280.0	

**SANITARY OR STORM SEWER ABANDONMENT OR REMOVAL**

\* Not a bid item

Location/Description	Sanitary or Storm Sewer	Abandonment, Plug Only or Abandonment, Plug and Fill or Removal	Length of Pipe		Fill Material*	Remarks
			≤ 36 inch diameter	> 36 inch diameter	Flowable Mortar or CLSM	
			LF	LF	CY	
1069+63.45, 42.2' Rt. - Apron	Storm Sewer	Removal				See Sheet M.4
78+71.7', 24" CMP Culvert	Storm Sewer	Removal	64			See Sheet M.4
85+68.60, 103' Rt. - Apron	Storm Sewer	Removal				See Sheet M.4
85+99.00, 103' Rt. - 24" Storm Pipe	Storm Sewer	Removal	48			See Sheet M.4
86+28, 114.6' Rt. - MH	Storm Sewer	Removal				See Sheet M.4
86+44.20, 158' Rt. - 24" Storm Pipe	Storm Sewer	Removal	80			See Sheet M.4
119+31.2 - 24' RCP Culvert	Storm Sewer	Removal	98			See Sheet M.6
146+89.05, 15.5' Rt. - Curb Intake	Storm Sewer	Removal				See Sheet M.8
149+10.70, 15.5' Rt. - Curb Intake	Storm Sewer	Removal				See Sheet M.8
3182+72.3, -Culvert	Storm Sewer	Removal	44			See Sheet M.11
3186+94, 15' Lt. - Entr. Culvert	Storm Sewer	Removal	46			See Sheet M.11
3190+36, 30' Lt. - 24" Entr. Culvert	Storm Sewer	Removal	68			See Sheet M.11
3191+43, 30' Rt. - Entr. Culvert	Storm Sewer	Removal	20			See Sheet M.11
3194+23, 35' Lt. - 24" Entr. Culvert	Storm Sewer	Removal	68			See Sheet M.11
3197+18, 35' Lt. - 24" Entr. Culvert	Storm Sewer	Removal	40			See Sheet M.12
3200+84, 27' Rt. - 18" Entr. Culvert	Storm Sewer	Removal	48			See Sheet M.12
3203+77, 33' Rt. - 36" Entr. Culvert	Storm Sewer	Removal	48			See Sheet M.12
3203+80, 47' Lt. - 21" Entr. Culvert	Storm Sewer	Removal	68			See Sheet M.12

103-7  
08-01-08

**SHRINKAGE DATA**

Material	%	Remarks
Class 10	30%	Estimated
Topsoil	40%	Estimated

103-4  
04-19-11

**TABULATION OF SPREADING TOPSOIL**

Perform this work according to Section 2105. Prior to placing topsoil on any cohesive soil, scarify the area to be covered to a minimum depth of 3 inches.

Appropriate adjustments have been made in the template quantities to reflect the placement of topsoil on foreslope, backslope and ditch bottom as detailed hereon.

Placement Description							Topsoil Excavation Available From				
Area	Quantity	Location		Side	Slope	(T)	Remarks	Amount Reserved	Station to Station		Remarks
No.	CY	Station to Station		L. or R.	B. or F.	IN		CY			
1	5720.0	78+50.00	118+60.00	L. & Rt.	B, F	6.0		5720.0	78+50.00	118+60.00	
2	3328.0	119+20.00	144+69.36	L. & Rt.	F	6.0		3328.0	119+20.00	144+69.36	
3	292.0	144+69.36	149+00.00	L. & Rt.	B, F	6.0		292.0	144+69.36	149+00.00	
4	217.0	984+50.00	987+20.00	L. & Rt.	B, F	6.0		217.0	984+50.00	987+20.00	
5	414.0	2091+20.00	2094+50.00	L. & Rt.	B, F	6.0		414.0	2091+20.00	2094+50.00	
6	1935.0	3181+00.00	3207+00.00	L. & Rt.	B, F	6.0		1935.0	3181+00.00	3207+00.00	
TOTAL	11906.0										

112-5  
10-20-15


**CONCRETE MEDIANS**

\* Bid item


Begin Station	End Station	Type	Area* SY	Modified Subbase CY	Special Backfill CY	Remarks
117+57.53	118+04.14	6 inch	65.9			MODIFIED SUBBASE INCLUDED IN PAVING
119+38.80	119+56.40	6 inch	51.6			MODIFIED SUBBASE INCLUDED IN PAVING
119+67.39	120+56.21	6 inch	73.6			MODIFIED SUBBASE INCLUDED IN PAVING
3187+36.76	3187+89.93	6 inch	74.4			MODIFIED SUBBASE INCLUDED IN PAVING
3189+22.55	3189+39.76	6 inch	45.1			MODIFIED SUBBASE INCLUDED IN PAVING
3189+50.71	3190+09.13	6 inch	42.4			MODIFIED SUBBASE INCLUDED IN PAVING





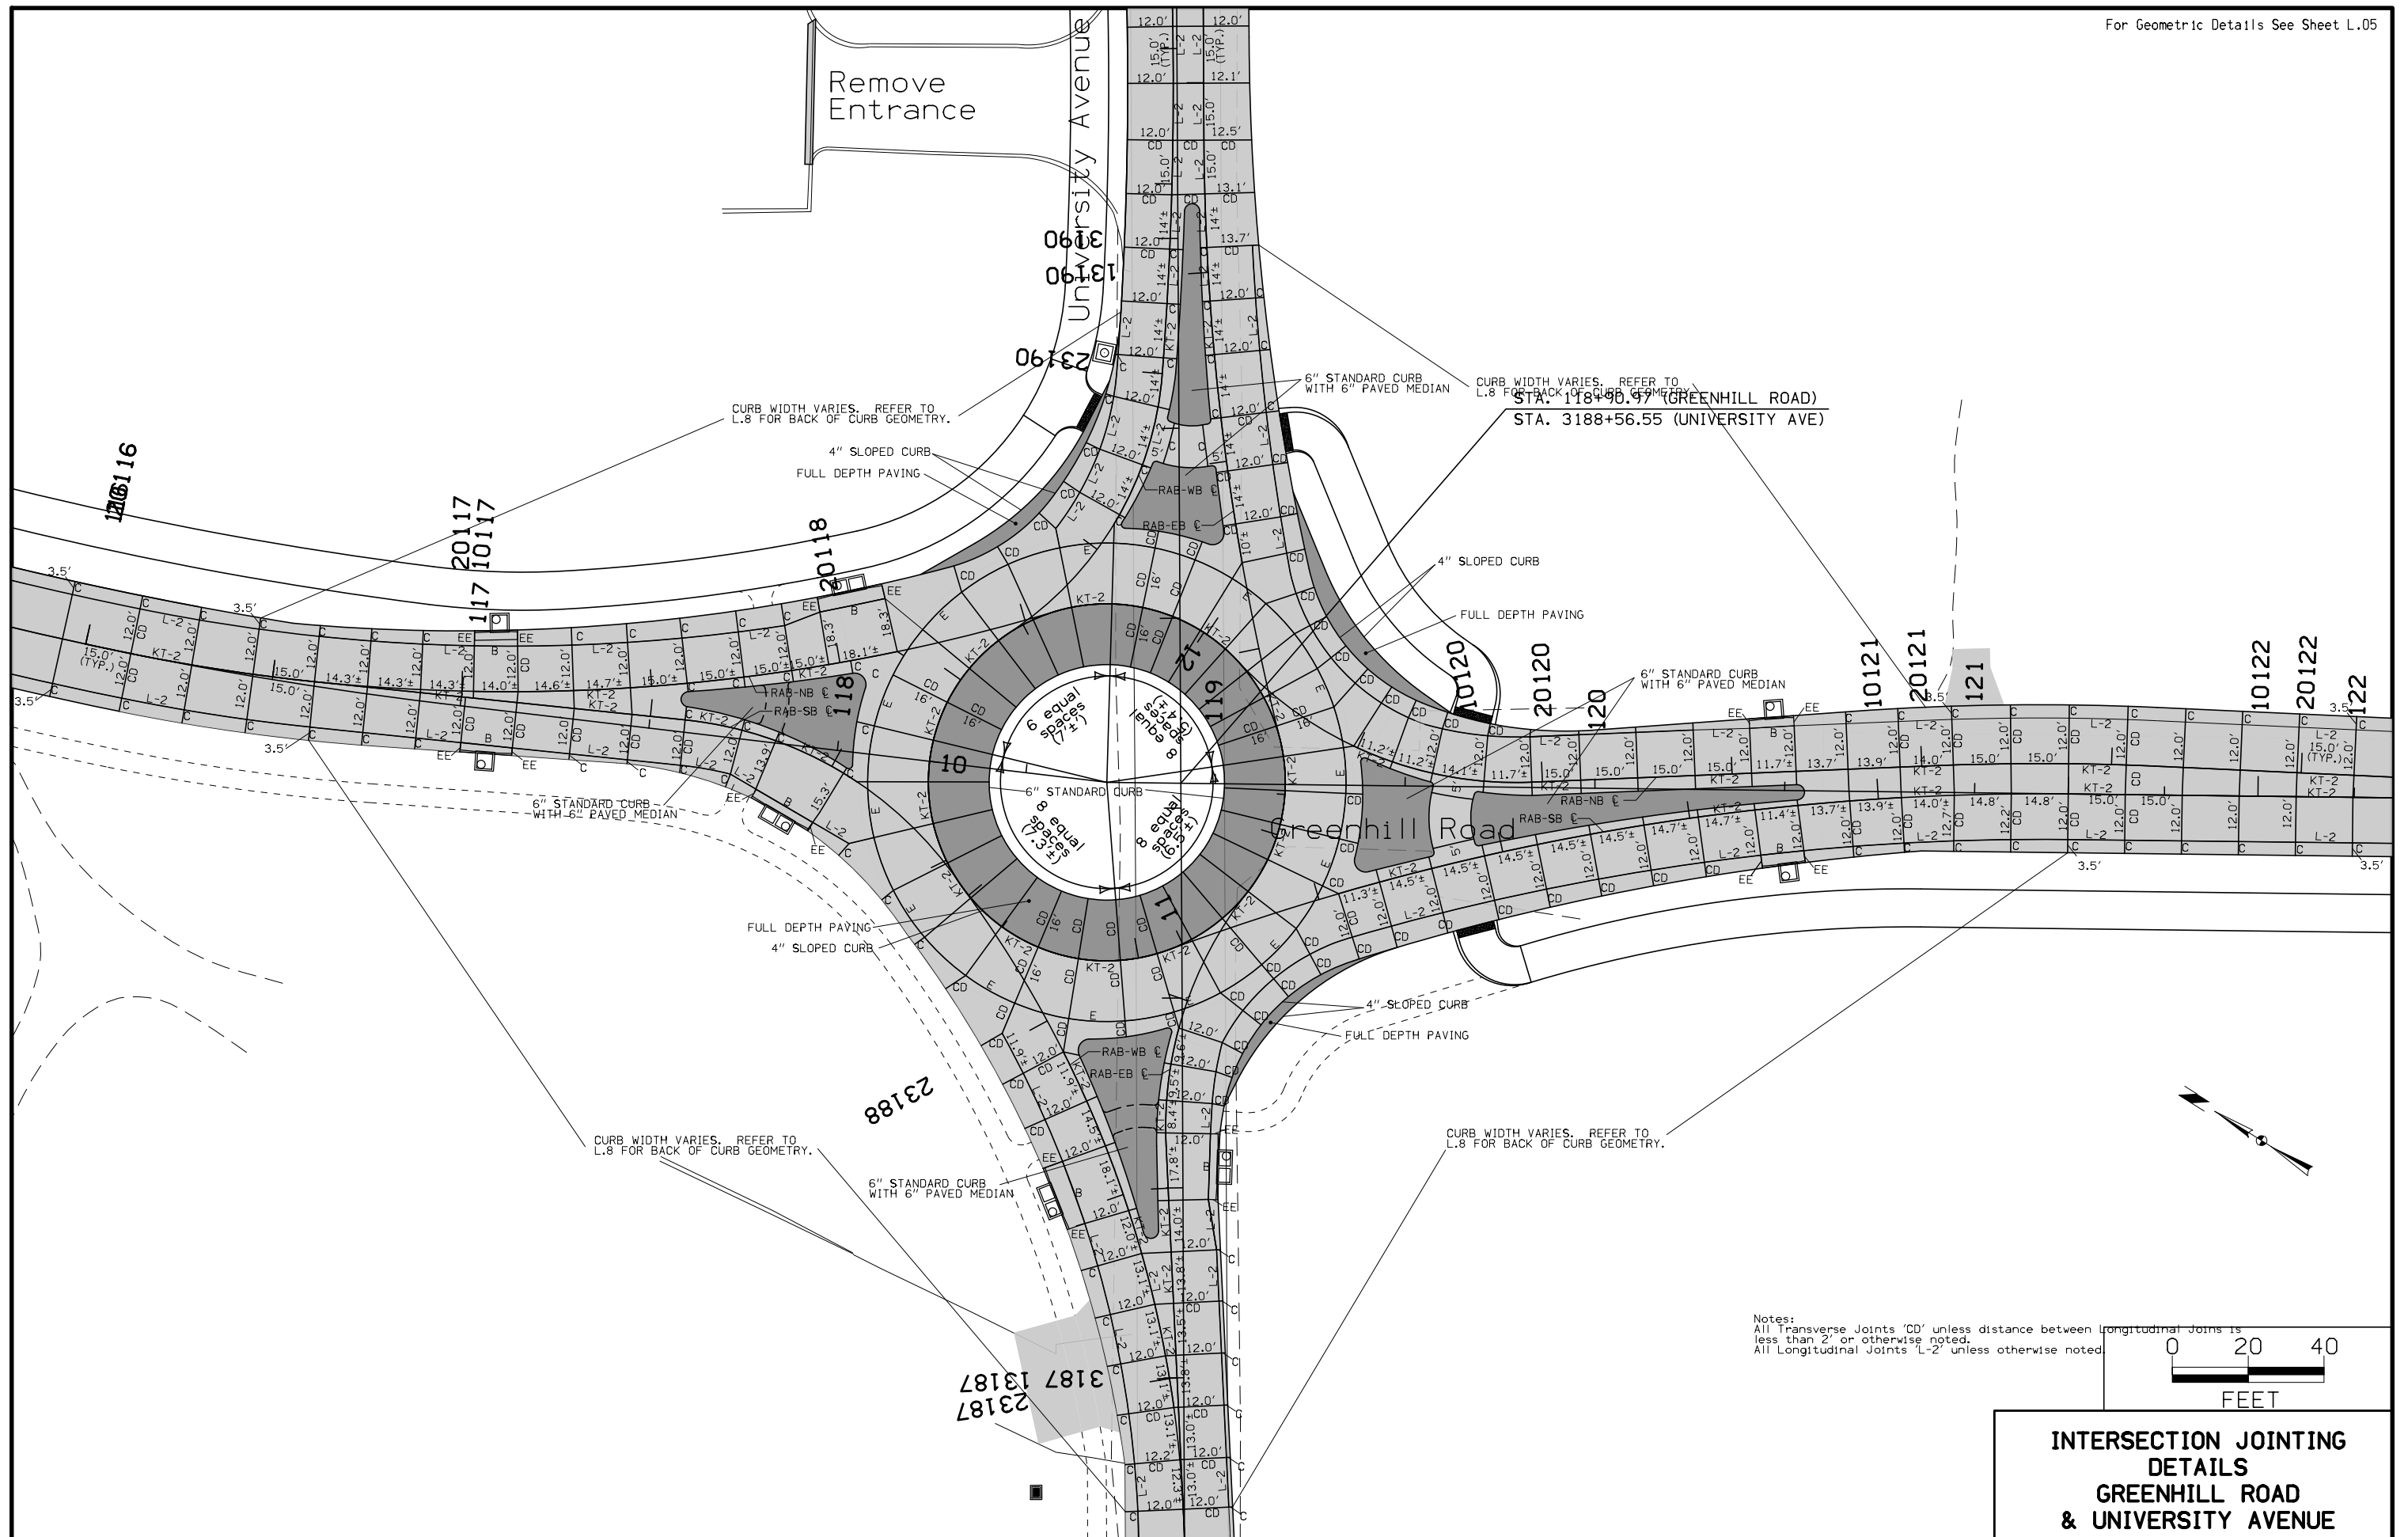

Notes:  
 All Transverse Joints 'CD' unless distance between longitudinal joints is less than 2' or otherwise noted.  
 All Longitudinal Joints 'L-2' unless otherwise noted.

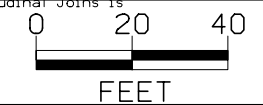

**INTERSECTION JOINTING  
 DETAILS  
 GREENHILL ROAD  
 & UNIVERSITY AVENUE**