# Addendum

Iowa Department of Transportation Date of Letting: June 20, 2017

Office of Contracts Date of Addendum: May 18, 2017

B.O.	Proposal ID	Proposal Work Type	County	Project Number	Addendum
151	00-000S-918	HMA RESURFACING	STATEWIDE	TSF-000-S(918)92-00	20JUN151A01

Make the following changes to the PROPOSAL SCHEDULE OF PRICES:

Change Proposal Line No. 0010 2214-5145150 PAVEMENT SCARIFICATION:

From: 1,411.400 SY To: 1,167.000 SY

Change Proposal Line No. 0020 2527-9263109 PAVEMENT MARKING, WATERBOURNE

OR SOLVENT BASED From: 412.060 STA To: 362.080 STA

Change Proposal Line No. 0030 2527-9263180 PAVEMENT MARKINGS REMOVED

From: 412.060 STA To: 362.080 STA

Change Proposal Line No. 0070 2599-9999018 ('SQUARE YARDS' ITEM) HIGH FRICTION

SURFACE TREATMENT From: 27,225.200 SY To: 24,152.600 SY

If the above changes are not made, they will be made as shown here.

Replace C.1, C.2, & C.3 with the attached plan sheets. Deleted plan sheets D.4 & D.5.

- Remove Sheets D.4 and D.5 from the plan set. This changes the sheet count on Sheet A.1 from 16 to 14.
- Tab. 102-16, Sheet C.1: Remove 4 lines for work on R22.
- Tab. 100-25, Sheet C.2: Remove both lines for R22.
- Tab. 108-22, Sheet C.3: Remove both lines for R22.

100-0A 10-28-97

**ESTIMATED ROADWAY QUANTITIES** (1 DIVISION PROJECT)

		(= ===================================			
Item No.	Item Code	Item	Unit	Total	As Built Qty.
1	2214-5145150	PAVEMENT SCARIFICATION	SY	1167.00	
2	2527-9263109	PAINTED PAVEMENT MARKINGS, WATERBORNE OR SOLVENT-BASED	STA	362.08	
3	2527-9263180	PAVEMENT MARKINGS REMOVED	STA	362.08	
4	2528-8445110	TRAFFIC CONTROL	LS	1.00	
5	2528-8445113	FLAGGER	EACH		
6	2533-4980005	MOBILIZATION	LS	1.00	
7	2599-9999018	HIGH FRICTION SURFACE TREATMENT	SY	24152.60	

100-4A	
10-29-02	

102-16 10-21-14

		ESTIMATE REFERENCE INFORMATION
Item No.	Item Code	Description
1	2214-5145150	PAVEMENT SCARIFICATION
		Refer to Tab. 102-16 for locations and additional information.
2	2527-9263109	PAINTED PAVEMENT MARKINGS, WATERBORNE OR SOLVENT-BASED
3	2527-9263180	PAVEMENT MARKINGS REMOVED
		Refer to Tab. 108-22 for locations and additional information.
4	2528-8445110	TRAFFIC CONTROL
		Refer to Sheet J.1 for traffic control information.
7	2599-9999018	HIGH FRICTION SURFACE TREATMENT
	2333-3339016	Refer to Tab. 100-25 for locations and quantities. Also refer to D sheets and Special Provisions.
		Neter to lab. 100-25 for locations and quantities. Also refer to b sheets and special riovisions.

## NOTCHES AND RUNOUTS FOR RESURFACING

Refer to PR-201 and PR-202.  $\stackrel{\text{\scriptsize (1)}}{1}$  Bid item. Applies only to Types 'N1' and 'N3' on PR-202. Refer to 100-25 for remaining values

Bid item.	Applies only to	Types 'N1'	and 'N3' or	n PR-202.	Reter to 10	<u> 10-25 tor r</u>	remaining values.	
Location Station	Type of Notch or Runout	S	I	DI	L	M	Pavement ① Scarification	Remarks
		IN	IN	IN	FT	IN	SY	
L20	Type 'N1'	0.5	0.0		25.0	0.5	61.1	South end
	Type 'N1'	0.5	0.0		25.0	0.5	61.1	North end
L35	Type 'N1'	0.5	0.0		25.0	0.5	66.7	South end
	Type 'N1'	0.5	0.0		25.0	0.5	66.7	North end
F65	Type 'N1'	0.5	0.0		25.0	0.5	66.7	West end
	Type 'N1'	0.5	0.0		25.0	0.5	66.7	East end
E29	Type 'N1'	0.5	0.0		25.0	0.5	61.1	South end
	Type 'N1'	0.5	0.0		25.0	0.5	61.1	North end
Iowa 5	Type 'N1'	0.5	0.0		25.0	0.5	66.7	South end
	Type 'N1'	0.5	0.0		25.0	0.5	66.7	North end
Iowa 137	Type 'N1'	0.5	0.0		25.0	0.5	66.7	West end
	Type 'N1'	0.5	0.0		25.0	0.5	66.7	East end
U.S. 6	Type 'N1'	0.5	0.0		25.0	0.5	66.7	West end
	Type 'N1'	0.5	0.0		25.0	0.5	66.7	East end
Y21	Type 'N1'	0.5	0.0		25.0	0.5	66.7	South end
	Type 'N1'	0.5	0.0		25.0	0.5	66.7	North end
Old Hwy Rd	Type 'N1'	0.5	0.0		25.0	0.5	61.1	West end
	Type 'N1'	0.5	0.0		25.0	0.5	61.1	East end

### **PROJECT DESCRIPTION**

This project is for installing asphalt friction courses on various roadways throughout the state.

105-4 10-18-11

HFST-1 MODIFIED

#### STANDARD ROAD PLANS

		The following Standard Road Plans apply to construction work on this project.
Number	Date	Title
PM-110	04-16-13	Line Types
PM-520	04-19-11	Two-Lane Roadway with no Turn Lanes (Two-Way Stop Condition)
PR-201	10-21-14	Runouts for Resurfacing
PR-202	10-21-14	Notches for Resurfacing (with or without Runout)
SI-881	10-18-16	Special Signs for Workzones
TC-1	04-16-13	Work Not Affecting Traffic (Two-Lane or Multi-Lane)
TC-202	04-21-15	Work Within 15 ft of Traveled Way
TC-213	04-17-12	Lane Closure with Flaggers
TC-233	04-18-17	Pavement Marking Operations Two-Lane

### **HFST Curve Data**

Curve Radius (feet)	Curve Length (feet)	Approach Speed (mph)	Advisory Speed (mph)	Runout Length (feet)	Remarks
573.0	662.7	55	40	154.0	
477.5	710.3	55	40	154.0	
716.3	682.8	55	40	154.0	
370 (est)	581 (est)	55	30	230.0	
1146.0	840.0	55	50	57.0	
1146.0	1089.8	55	50	57.0	
636.6	410.0	55	40	154.0	
955.0	1075.5	55	45	108.0	
716.3	680.0	35 / 55	45	108.0	

ENGLISH DESIGN TEAM Snyder & Associates, Inc.

Route

Iowa 5 Iowa 137 U.S. 6

Old Hwy Rd.

County

Guthrie Marshall Marion


Johnson Dubuque

Pottawattamie L20 Pottawattamie L35

Statewide COUNTY PROJECT NUMBER TSF-000-S(918)--92-00

SHEET NUMBER

## **Surface Treatment**

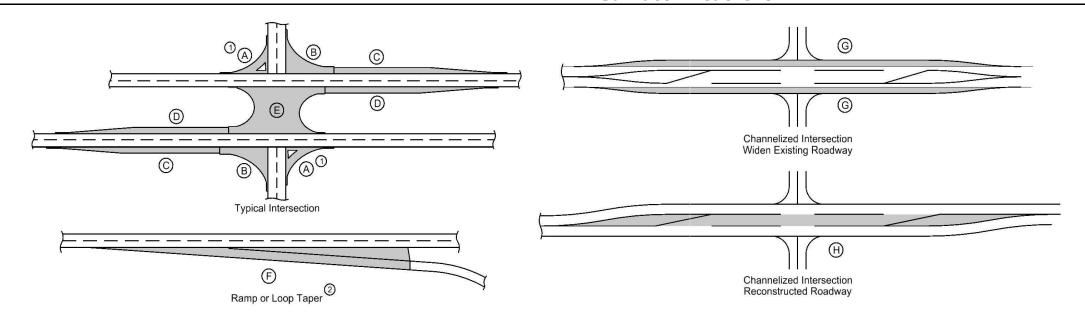

- 1 Does not include raised island area or curb. Refer to tabulation 112-4 for quantities.
- 2 Refer to PV-410, PV-411, PV-412, and PV-414.
- 3 Quantity includes Pavement Header.

	Location				2				Δ	rea (3)				Bid Items													
														Hot Mix Asphalt Pavement						Binder			'	1 -			
Road Identification	Direction of Travel	Station to Station	Width	Length	Area	(1) (A)	В	С	D	E	(2) (F)	G	Н	Surface	Interm	ediate	Ва	se	Surface	Intermediate	Base	Special Backfill	Modified Subbase		Pavement Scarificatio	200	
			FT	FT	SY	SY	SY	SY	SY	SY	SY	SY	SY	TONS SY	TONS	SY	TONS	SY	TONS	TONS	TONS	TONS	CY	SY	SY	l.	
L20	BOTH		22.0	971.0	2373.6									2373.6													
L35	BOTH		29.0		3286.7									3286.7													
F65	BOTH		24.0	991.0	2642.7									2642.7													
E29	BOTH		22.0	1041.0	2544.7									2544.7													
Iowa 5	BOTH		24.0	954.0	2544.0									2544.0													
Iowa 137	BOTH		24.0	1204.0	3210.7									3210.7												T	
U.S. 6	BOTH		24.0	718.0	1914.7									1914.7													
Y21	BOTH		24.0	1292.0	3445.3									3445.3													
Old Hwy Rd	BOTH		22.0	896.0	2190.2									2190.2												T	

#### PAVEMENT MARKING LINE TYPES

See PM-110

\*BCY4 - Place on the same side of the roadway to match existing markings near the project.

\*\*NPY4 - For estimating purposes only. No Passing Zone Lines will be located in the field.

BCY4: Broken Centerline (Yellow) @ 0.25

ELY4: Edge Line Left (Yellow) @ 1.00

DLW4: Dotted Line (White) @ 0.33

\*\*\*MNY4 - Factor of 1.00 as value includes number of 4-inch passes to cover median nose area.

NPY4: No Passing Zone Line (Yellow) @ 1.25 SLW4: Solid Lane Line (White) @ 1.00

BLW4: Broken Lane Line (White) @ 0.25 CHY8: Channelizing Line (Yellow) @ 2.00

ELW4: Edge Line Right (White) @ 1.00

Location								Length by Line Type (Unfactored)													
Road ID	Station to Station	Dir. of Travel	Marking Type		Side	BCY4*	DCY4	NPY4**	BLW4	ELW4	ELY4	DLW4	SLW4	CHY8							Remarks
1.20			Hatanhama (Calamat Balat		C R		STA	STA	STA	STA	STA	STA	STA	STA	STA	STA	STA	STA	STA	STA	
L20		BOTH	Waterborne/Solvent Paint		XX		9.71			19.12											
		BOTH	Removal of Paint		X X		9.71			19.12											
L35		BOTH	Waterborne/Solvent Paint		XX		10.20			20.10											
		BOTH	Removal of Paint		X X		10.20			20.10											
F65		BOTH	Waterborne/Solvent Paint		X X		9.91			19.82			_								
		BOTH	Removal of Paint		X X		9.91			19.82					-						
E29		BOTH	Waterborne/Solvent Paint		X X		10.41			20.82											
		BOTH	Removal of Paint		X X		10.41			20.82											
Iowa 5		BOTH	Waterborne/Solvent Paint		X X		9.54			19.08											
		BOTH	Removal of Paint		X X		9.54			19.08											
Iowa 137		BOTH	Waterborne/Solvent Paint		X X		12.04			24.08											
		BOTH	Removal of Paint		X X		12.04			24.08											
U.S. 6		BOTH	Waterborne/Solvent Paint	X	X X		7.18			13.86											
		BOTH	Removal of Paint	X	X X		7.18			13.86											
Y21		BOTH	Waterborne/Solvent Paint	X	X X		12.92			25.84											
		BOTH	Removal of Paint	X	ХХ		12.92			25.84											
Old Hwy Rd		BOTH	Waterborne/Solvent Paint	X	ХХ		8.96			17.62											
		BOTH	Removal of Paint	X	X X		8.96			17.62											
			Factored Total: Waterborne/Solvent Paint			-	181.74	-	-	180.34	-	-	_	-	-	-	-	-	-	-	
			Factored Total: Removal of Paint			-	181.74	-	-	180.34	-	-	-	-	-	-	-	-	-	-	
			Bid Quantity: Painted Pavement Markings, Wat	erborne	or Solv	ent-Based			362.08												
			Bid Quantity: Pavement Markings Removed						362.08												

ENGLISH DESIGN TEAM Snyder & Associates, Inc.

Statewide COUNTY PROJECT NUMBER

TSF-000-S(918)--92-00

SHEET NUMBER