Addendum

Iowa Department of Transportation Date of Letting: July, 18, 2017

Office of Contracts Date of Addendum: July 11, 2017

В	. O.	Proposal ID	Proposal Work Type	County	Project Number	Addendum
0	09	49-0521-097	BRIDGE REPLACEMENT - PPCB	JACKSON	BRFN-052-1(97)39-49	18JUL009A02

Make the following change to Proposal Details, page 2:

Change Site Number 03 from 10 working days to 25 working days.

Make the following changes to the PROPOSAL SCHEDULE OF PRICES:

Add Proposal Line No. 0211 2402-2722000 EXCAVATION CLASS 22; 60.000 CY

If the above changes are not made, they will be made as shown here.

Replace plan sheets 2, J.1, & Q.1 with the attached sheets:

Sheet 2 - Added Class 22 excavation quantity & reference information.

Sheet J.1 - Site 3 notes.

Sheet Q.1- Revised note No.11

Attached are the pre-bid meeting minutes and attendance list:

ESTIMATED BRIDGE QUANTITIES TOTAL 3 AS BUILT 4 ITEM NO. ITEM CODE UNIT ITEM QUAN. ALTERNATE AA ALTERNATE AA ALTERNATE BB ALTERNATE BE OPTION I OPTION 2 OPTION I OPTION 2 598.8 2104-2710020 EXCAVATION, CLASS 10, CHANNEL 2401-6745625 REMOVAL OF EXISTING BRIDGE LS 1.00 2402-2720000 EXCAVATION, CLASS 20 CY 222 STRUCTURAL CONCRETE (BRIDGE) CY 394.8 445.7 171.8 2403-0100010 246 326,891 2404-7775000 REINFORCING STEEL LB 386,770 23,436 2404-7775005 REINFORCING STEEL, EPOXY COATED LB 20,293 74,517 REINFORCING STEEL, STAINLESS STEEL 2404-7775009 LB 472 604 1,456 BEAMS, PRETENSIONED PRESTRESSED CONCRETE, SBTB90 2407-0550000 EACH 10 2407-0550000 BEAMS, PRETENSIONED PRESTRESSED CONCRETE, SBTB95 EACH 10 BEAMS, PRETENSIONED PRESTRESSED CONCRETE, BTB90 FΔCH 10 2407-0562890 10 2407-0562895 BEAMS, PRETENSIONED PRESTRESSED CONCRETE, BTB95 EACH 10 6417 1,552 2408-7800000 STRUCTURAL STEEL LB 2,328 12 13 2414-6424110 CONCRETE BARRIER RAILING LF 814.0 CONCRETE DRILLED SHAFT, 72 IN. DIAMETER 894 14 2433-0001072 LF LOAD CELL TEST FΔCH 15 2433-0002000 16 2433-0003000 DEMONSTRATION SHAFT LF 150 2501-0201057 PILES, STEEL, HP 10 X 57 2,760 17 LF 18 2501-6335010 PREBORED HOLES LF 360 SY 299.4 19 2507-3250005 ENGINEERING FABRIC TON 464-0 REVETMENT, CLASS E 20 2507-6800061 CONSTRUCTION SURVEY 1.00 2526-8285000 LS 22 MOBILIZATION 1.00 2533-4980005 LS 2599-9999005 PRECAST DECK OVERHANG PANELS FACH 70 23 EACH 24 2599-9999005 FULL DEPTH PRECAST DECK PANELS 70 17,019 25 2599-9999008 POST-TENSIONING TENDONS LB ACCELBRIDGE DECK COMPRESSION 26 2599-9999010 LS 1.0 2599-9999010 BOAT RAMP RECOVERY LS 1.0 27

LS

TON

CY

1.0

3,601.7

60

ITEM	CODE	ESTIMATE REFERENCE INFORMATION
1		EXCAVATION BELOW GRADING SURFACE REQUIRED TO PLACE EMBEDDED REVETMENT ON BRIDGE BERM.
2		INCLUDES REMOVAL OF EXISTING 120' x 20' HIGH TRUSS SPAN AND 4-55' x 20' I-BEAM APPROACH SPANS.
3		QUANTITY BASED ON THE ASSUMPTION THAT THE CHANNEL EXCAVATION IS COMPLETED PRIOR TO STARTING CONSTRUCTION OF THE ABUTMENTS.
4		INCLUDES THE CONCRETE FOR THE ABUTMENTS, PIERS AND CIP CONCRETE DECK. INCLUDES ALL PREFORMED EXPANSION JOINT FILLER REQUIRED. INCLUDES FURNISHING AND PLACING SUBDRAIN (INCLUDING EXCAVATION), FLOODABLE BACKFILL, POROUS BACKFILL, GEOTEXTILE FABRIC, WATER FLOODING, AND SUBDRAIN OUTLET AT ABUTMENTS. INCLUDES FURNISHING AND PLACING 3 INCH DIAMETER PVC PLASTIC PIPE AND EXPANDING FOAM IN THE ABUTMENT WINGS. INCLUDES FURNISHING AND PLACING PRECAST CONCRETE DECK PANELS IN DIVISION 2.
6		INCLUDES COST OF 96 EPOXY COATED REINFORCEMENT COUPLERS (FOR DIVISION 3 DESIGN).
8,	, 9	INCLUDES PIER AND ABUTMENT BEARING MATERIAL, INCLUDES EMBEDDED TOP FLANGE STEEL PLATES AND EMBEDDED STUDS, NONSTANDARD STIRRUP LENGTHS AND LAYOUT ARE USED FOR THIS BEAM.
10	0, 11	INCLUDES PIER AND ABUTMENT BEARING MATERIAL, NONSTANDARD STIRRUP LENGTHS ARE USED FOR THIS BEAM.
12	2	INCLUDES 24 DRAINS AT 97 LB EACH IN DIVISION 2 DESIGN. INCLUDES 16 DRAINS AT 97 LB EACH IN DIVISION 3 DESIGN.
1;	3	IF PLACEMENT OF CONCRETE IS DONE BY THE SLIPFORMING METHOD, CLASS BR CONCRETE IS REQUIRED. CAST-IN-PLACE BARRIER RAILS SHALL USE CLASS C MIX. PRICE BID FOR THIS ITEM SHALL INCLUDE THE COST OF CAST-IN-PLACE FORMS IF REQUIRED FOR PLACEMENT OF THE CONCRETE, INCLUDES 822 L.F. OF 2" DIA. RIGID STEEL CONDUIT, INCLUDES MATERIAL AND LABOR ASSOCIATED WITH PROVIDING AND INSTALLING RIGID STEEL CONDUIT, JUNCTION BOXES AND FITTINGS.
1.	4	INCLUDES COST OF C.S.L. TESTING AT EACH SHAFT, SUBMITTAL OF A DRILLED SHAFT INSTALLATION PLAN SHALL BE REQUIRED. LENGTH MEASURED FROM BOTTOM OF DRILLED SHAFT TO CONSTRUCTION JOINT.
10	6	THE DEMONSTRATION SHAFT SHALL BE AS DETAILED ON DESIGN SHEET 8 AND SHALL NOT BE DELETED. THE DEMONSTRATION SHAFT SHALL BE USED AS THE TEST SHAFT. INCLUDES ALL COSTS OF MATERIALS AND LABOR INCLUDING CONCRETE, REINFORCING STEEL, EXCAVATION AND EXCAVATION INCIDENTALS INCLUDING CASING AND C.S.L. TESTING OF THE SHAFT.

2599-9999010

2599-9999020

2402-2722000

11:03:39 AM untitled

29

30

VIBRATION MONITORING

EXCAVATION, CLASS 22

REVETMENT, CLASS X

ITEM CODE

ESTIMATE REFERENCE INFORMATION

- ENGINEERING FABRIC SHALL BE MATERIAL AS SPECIFIED FOR EMBANKMENT EROSION CONTROL IN ACCORDANCE WITH ARTICLE 4196,01.B.3. OF THE STANDARD SPECIFICATIONS.
- ESTIMATED AT 1.6 TON/CY. BROKEN CONCRETE WILL NOT BE ALLOWED AS A SUBSTITUTE FOR REVETMENT.
- INCLUDES ALL COSTS OF MATERIALS. EQUIPMENT AND LABOR INCLUDING CONCRETE. REINFORCING STEEL AND PLACING THE OVERHANG PANELS.
- INCLUDES ALL COSTS OF MATERIALS AND COSTS ASSOCIATED WITH FURNISHING AND PLACING PRECAST DECK PANELS. INCLUDES FIELD WELDING STEEL CONNECTION PLATES AND STUDS. REFER TO FULL DEPTH PRECAST DECK SYSTEM SPECIAL PROVISIONS FOR ADDITIONAL INFORMATION.
- INCLUDES ALL COSTS OF MATERIALS, EQUIPMENT AND LABOR ASSOCIATED WITH PLACING, STRESSING AND GROUTING TENDONS REFER TO POST-TENSIONING SPECIAL PROVISIONS FOR ADDITIONAL INFORMATION.
- INCLUDES ALL COSTS OF MATERIALS, EQUIPMENT AND LABOR TO APPLY DECK COMPRESSION FORCES. REFER TO ACCELBRIDGE DECK COMPRESSION SPECIAL PROVISIONS FOR ADDITIONAL INFORMATION.
- REFER TO BOAT RAMP RECOVERY SPECIAL PROVISION FOR ADDITIONAL INFORMATION.
- 28 REFER TO SPECIAL PROVISIONS FOR VIBRATION MONITORING FOR ADDITIONAL INFORMATION.
- REVETMENT, CLASS X SHALL BE FURNISHED AND PLACED IN CONFORMANCE WITH SECTION 2507 OF THE STANDARD SPECIFICATIONS, CONCRETE AND STONE REVETMENT, CLASS B REVETMENT, MODIFIED AS FOLLOWS:

THE PROVISIONS OF SECTION 4130.02,A,2 OF THE STANDARD SPECIFICATIONS, REVETMENT GRADATION, ARE MODIFIED AS FOLLOWS:

NOMINAL TOP SIZE OF 1,200 POUNDS.

AT LEAST 20% OF THE STONES ARE TO WEIGH MORE THAN 900 POUNDS. AT LEAST 50% OF THE STONES ARE TO WEIGH MORE THAN 500 POUNDS.

AT LEAST 90% OF THE STONES ARE TO WEIGH MORE THAN 50 POUNDS.

- BROKEN CONCRETE WILL NOT BE ALLOWED AS A SUBSTITUTE FOR REVETMENT. MEASUREMENT WILL BE IN TONS TO THE NEAREST O.I TON. ONLY MATERIAL PLACED IN ACCORDANCE WITH THE CONTRACT DOCUMENTS WILL BE MEASURED. FOR CONSTRUCTION OF CLASS X REVETMENT, THE CONTRACTOR WILL BE PAID THE CONTRACT PRICE PER TON FOR THE QUANTITY OF REVETMENT FURNISHED AND PLACED, ESTIMATED AT 1.6 TON/CY.
- FOR REMOVING REVETMENT THAT MAY BE OVER DRILLED SHAFT AREAS.

DIVISIONS:

- BID ITEMS THAT ARE COMMON TO ALL CONTRACTOR CHOICES
- BID ALTERNATE AA OPTION I IF SELECTING PARTIAL DEPTH PRECAST DECK OPTION
- BID ALTERNATE AA OPTION 2 IF SELECTING FULL DEPTH PRECAST DECK OPTION
- BID ALTERNATE BB OPTION I IF SELECTING CAST IN PLACE PIER CAP OPTION
- BID ALTERNATE BB OPTION 2 IF SELECTING POST-TENSIONED PIER CAP OPTION

NOTE: CONTRACTOR WILL BID DIVISION I, DIVISION 2 OR 3 AND DIVISION 4 OR 5.

DESIGN FOR 45° SKEW (L.A.)

376'-0 x 40' PRETENSIONED PRESTRESSED CONCRETE BEAM BRIDGE 97'-0 INTERIOR SPANS

91'-0 END SPANS

QUANTITIES

STATION: 1448+10.00

JACKSON COUNTY

IOWA DEPARTMENT OF TRANSPORTATION - HIGHWAY DIVISION DESIGN SHEET NO. 1 OF 61 FILE NO. 31055 DESIGN NO. 117

PARSONS EAR/JZ/SC JACKSON COUNTY PROJECT NUMBER BRFN-052-I(97)--39-49

ROADWAY QUANTITIES SHOWN

ELSEWHERE IN THESE PLANS.

NOTE:

SHEET NUMBER

MAY, 2015

108-23A 08-01-08

TRAFFIC CONTROL PLAN

Two lanes of traffic on U.S. Highway 52 shall be maintained, except as noted below.

- 1. Traffic may be reduced to one lane in each direction.
- 2. Traffic shall be detoured off-site for removal and replacement of the bridge. See sheets J.2-J.3 for route and signing details.
- A. Detour signing in Iowa shall be maintained by the Contractor.

 B. Detour signing in Illinois shall be installed and maintained by Illinois DOT.

111-01 04-17-12

COORDINATED OPERATIONS

Other work in progress during the same period of time will include the construction of the projects listed. Coordinate operations with those of other contractors working within the same area.

Project	Type of Work
2017	
BRFN-052-1(98)39-49	Bridge Removal and Replacement
BRFN-052-1(101)39-49	Bridge Cleaning
HSIPX-64-2(57)3L-49	HMA Resurfacing w/Milling
STPN-67-3(6)2J-49	Pipe Culverts
FS-49-15-DWSRF-019	Water Main and Meters
2018	
BRFN-052-1(98)39-49	Bridge Removal and Replacement
BRFN-052-1(105)39-49	Bridge Cleaning
BRFN-136-1(75)39-23	Bridge Cleaning

STAGING NOTES

Traffic: U.S. 52 traffic in normal lanes. Temporary closures (TC-251) may be required.

Construction: Drilled bridge shafts will be drilled outside the limits of the existing structure via the use of a barge.

Traffic: U.S. 52 traffic shall be detoured off-site (maintained by Contractor)

Construction:

Remove existing bridge

Construct new bridge

Construct new roadway on both ends of the new bridge

Traffic: U.S. 52 traffic returned to normal lanes on new roadway and bridge.

Construction: To complete project cleanup and boat ramp restoration in Stage 3 after US 52 is open to traffic.

Standard Specification 1108.09B does not apply to this site.

10-21-14

108-26A 08-01-08

511 TRAVEL RESTRICTIONS

Route	Direction	County	Location Description	Feature Crossed	Object Type	Maint. Bridge No., Structure ID, or FHWA No.	Type of Restriction	Existing Measurement	Construction Measurement	Construction Measurement as Signed	Projected As Built Measurement	Remarks
US 52	N/S	Jackson	Mississippi River	Mississippi River	Bridge	000.0S052, 29940	Vertical	17' 0"				(1)
US 52	N/S	Jackson	Mississippi River Overflow	Mississippi River Overflow	Bridge	002.05052, 29950	Vertical	14' 01"				(1) (2)
IA 136	N/S	Clinton	Mississippi River & RR	Mississippi River	Bridge	000.0S136, 21055	Vertical	16' 05"				(3)
Notes:												
			r Iowa routes only. Coordination with the Illi	nois 511 is needed								
(1)												
(2)	Project Location											
(3)	Detour Rout	e										


FILE NO. **31055** ENGLISH DESIGN TEAM Flattery\Bell JACKSON COUNTY PROJECT NUMBER

BRFN-052-1(97)--39-49

SHEET NUMBER

J.1 REVISED **7/7/2017**

Changed By Addenda

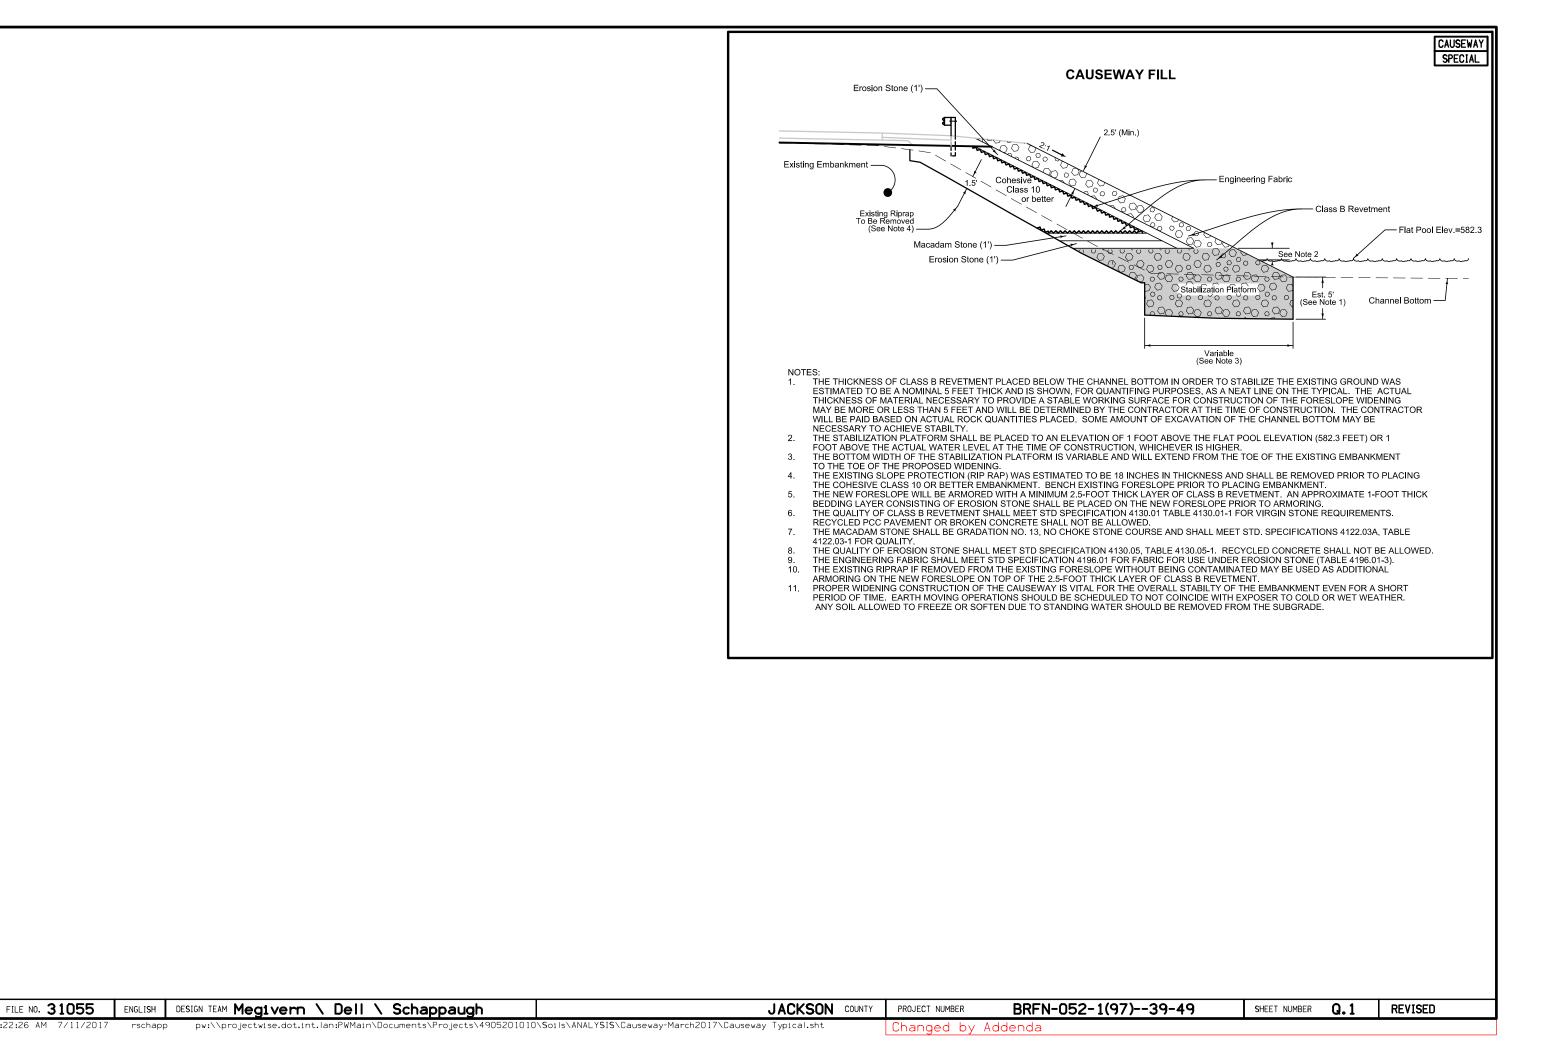

Pre-Bid Meeting Notes

Bridge Replacement - PPCB

US 52 / IA 64 over Mississippi River Overflow in Sabula

10:30 a.m. to Noon

NW Wing 1st Floor Conference Room

Thursday, June 29, 2017

Opening Remarks:

5 minutes

Krandel Jack, Office of Contracts

Proposal and Contract Period Overview

5 minutes

Krandel Jack, Office of Contracts

Doug McDonald, District 6

Bridge Replacement Overview

30 minutes

Project Details – Joanne Zuo, Parsons

Full Depth Deck Panel AccelBridge Details – Bob Magliola, Parsons

Contractor Questions

50 minutes

Note – The pre-bid meeting questions and answers were edited for clarity. Some answers were not known or given at the time of the pre-bid meeting and written answers are being provided below after the meeting.

Q1. For the full depth precast deck AccelBridge option the plan details indicate the longitudinal joint is UHPC and the shear pockets and haunches are grout?

A1. Correct.

Q2. For the full depth precast deck AccelBridge option the plan details indicate a cast-in-place pier diaphragm with suggested 8-inch diameter holes in the full depth precast deck for concrete placement. Can the holes be filled with concrete at the same time as the cast-in-place diaphragm?

A2. Yes.

- Q3. For the full depth precast deck AccelBridge option there is some cast-in-place concrete at the abutments and for the partial depth deck panel option there is some cast-in-place concrete overhang forming at the piers?
- A3. Correct due to the skew of the bridge.
- Q4. Would a VE proposal be considered to change to a cast-in-place bridge deck?
- A4. Yes, in accordance with Standard Specifications 1105.14. There will be no consideration for increasing the number of calendar days for site 2. There are no research funding or demonstration project funding associated with the project that require a partial depth deck panel or full depth deck panel system for accelerated bridge construction to be used.
- Q5. Does public access to the boat ramp need to be maintained during construction or can it be closed?
- A5. The boat ramp can be closed for construction. See the Special Provisions for Boat Ramp Recovery for details.
- Q6. Would you consider increasing the working days for site 3 that is currently 10 working days? The timeframe is very tight for completing the work remaining in site 3.
- A6. See addendum.

- Q7. Does site 2 incentive/disincentive apply to the boat ramp closure?
- A7. The critical closure for site 2 applies to the roadway traffic. Calendar days are counted when the detour is in effect.
- Q8. Is river access on the Illinois side of the bridge needed or provided?
- A8. It is anticipated that Illinois side river access is needed to install the drilled shafts in site 1 construction. No access has been obtained in advance (like the City of Sabula boat ramp on the lowa side) since there are several commercial access areas on the Mississippi River (Illinois side).
- Q9. For the full depth precast deck AccelBridge option does the foam haunch forming system come with the AccelBridge product?
- A9. The plans indicate to form or shim the haunch location and the exact forming is left to the contractor's means and methods.
- Q10. Which precast components are required to be shop produced?
- A10. The following precast components are required to be produced in a plant for which equipment, procedures and quality of concrete have been approved by the DOT per Materials I.M. 570; precast concrete beams, partial depth precast deck panels, AccelBridge full depth precast deck panels.
- Q11. For the full depth precast deck AccelBridge option are there curing requirements?
- A11. Concrete curing specifications are stated in the Special Provisions for AccelBridge Full Depth Precast Deck Panels 150286.03, G.
- Q12. Can you access the east side of the bridge from the City of Sabula boat ramp located west of the bridge?
- A12. No access has been obtained in advance on the east side of the bridge by the DOT. There is only an agreement with the City of Sabula for boat ramp access on the west side of the bridge.

- Q13. There is concern about the class X revetment that has been dumped in the scour holes around and downstream of the existing bridge for conflict with installation of the drilled shafts. How will the contractor bid and be paid for the removal of the class X revetment in order to install the drilled shafts?
- A13. See addendum.
- Q14. Is there a topo of the river bottom for calculating dredging quantity?
- A14. Plan sheet numbers 5,6 and 62 have topographic information. A sonar image is also available that will be posted on BidX along with a bathymetric survey.
- Q15. Are there any restrictions on night work?
- Q15. The City of Sabula may have ordinances such as noise ordinances that would affect the contractor's ability to do night work. The City of Sabula should be contacted.
- Q16. For the full depth precast deck AccelBridge option are there any concerns of panel uplift during the jacking operation to install the pre-compression?
- A16. No, the panels joined together with the bolts and panel self-weight resist the upward forces that may develop.
- Q17. For the full depth precast deck AccelBridge option are there any concerns with the panel movement during jacking and interference between the shear pockets and shear reinforcement?
- A17. No, the movement is small and the pockets are sized to accommodate the movement.
- Q18. How many addendums are anticipated for the project? What will be the timing of the release of the addendums.
- A18. There will be at least one addendum. Addendums will be released as soon as ready.
- Q19. Is the handling/lifting of the partial depth deck panel option addressed in the plans?

- A19. Plan sheet number 24 indicates the partial depth interior deck panel lifting hook details. See addendum A01 for partial depth precast overhang panels note on design sheet 20 of 61.
- Q20. What are the weights of the precast panels?
- A20. The weights can be calculated from the given plan details and dimensions.
- Q21. Can the drilled shaft permanent casing be lengthened?
- A21. No, the shaft resistance is developed in side friction.
- Q22. Can polymer slurry for drilled shaft construction be disposed in the river?
- A22. See Standard Specifications 2433.03, C.
- Q23. Is a particular slurry required, bentonite v. polymer?
- A23. The Standard Specifications allow for a mineral or polymer slurry. The slurry choice is left to the contractors means and methods.
- Q24. Does the mass concrete specification apply to the precast pier cap?
- A24. Yes.
- Q25. Are the existing bridge plans available?
- A25. The existing bridge plans the DOT has available are posted in the project E-files.

Pre-Bid sign in sheet Jackson County, US 52 Bridge Replacement – PPCB Project BRFN-052-1(97)--39-49

NAME	COMPANY	EMAIL ADDRESS	PHONE & FAX #
Krandel Jack	Iona DOT Contracts	Krandel. jeck @10wadot.us	515-239-1546 515-239-1325
Joanne Zuo	parsons	joanne. Zuo Q parsons. Com	312-930-5195
Bob Maglida	Parsons	Robert. A. Magliola @ Parsons. Com	312-930-5192
Jim Nelson	Iowa DOT	James. S. Nelson iowadot. gov	515 239-1143
Krista Taylor	Taylor Constructor	Ktaylore taylorcon Str. Com	563-921-3845
BON OHO	Agciowa	rottogagcia.org	515-509-5725
THER JAMES	CASE FOUNDATED COMPANY	FUNDATION, COM	224-238 - 0836

Pre-Bid sign in sheet Jackson County, US 52 Bridge Replacement – PPCB Project BRFN-052-1(97)--39-49

NAME	COMPANY	EMAIL ADDRESS	PHONE & FAX #
Dennis Drews	Coreslab Structures	delreus e Coreslab.com	402-291-0733 -
CHASE ANSELMI	BRANST CONSTRUCTION	CANSELMI @ BRANDTIONSTEUCHIONCO.	402-291-2598- 309-787-4644-P 309-787-6344-F
Brian Jacob	Cramer and	bjawb@	515 2651447
Landon	Associates Fre. Jensen	Craneradassocialisi Listreite	515-266-5173
Streit	Construction	Jewen Const. con	515-266-5152
RYAN CHEESEMAN	JENSEN CONSTRUCTION	RCHRESEMAN & LENSEN (ONST.	515-766-5173 515-766-5157
BRENT FREEMAN	KRAEMER NORTH AMERICA	BFREEMAN @ KRAEMERNA.COM	608-434-4713
JOSH DUDRAK	KNA	JOUCEAKEKEAEM	EEN.A.COM (608) 596-7311 (608) 596-7518

Pre-Bid sign in sheet Jackson County, US 52 Bridge Replacement – PPCB Project BRFN-052-1(97)--39-49

NAME	COMPANY	EMAIL ADDRESS	PHONE & FAX #
Jim Siegel	Forterra	jim. siegele forterrapp.co	· ·
KEN ScHROUK	CONSTRUCTORS	KSCHROCKO CIVILING, COM	815,235, 2200
JEFF YODER	TAYLOR CONSTRUCTION,	jyder@łaybrconstr. a	563-921-2315 pm F2×563-921-3845
Matt Erickson	IA DOT	matthew. crickson @ lowedot. US	
RON FAABORG	UNITED CONTRACTORS INC	UCIQUNITED CONTRACTORSO NET	515-276-6167 276-3053
Dou C Mc Donaco	TA DOT	douglas, medonall Quowadot, us	319-364-0235